


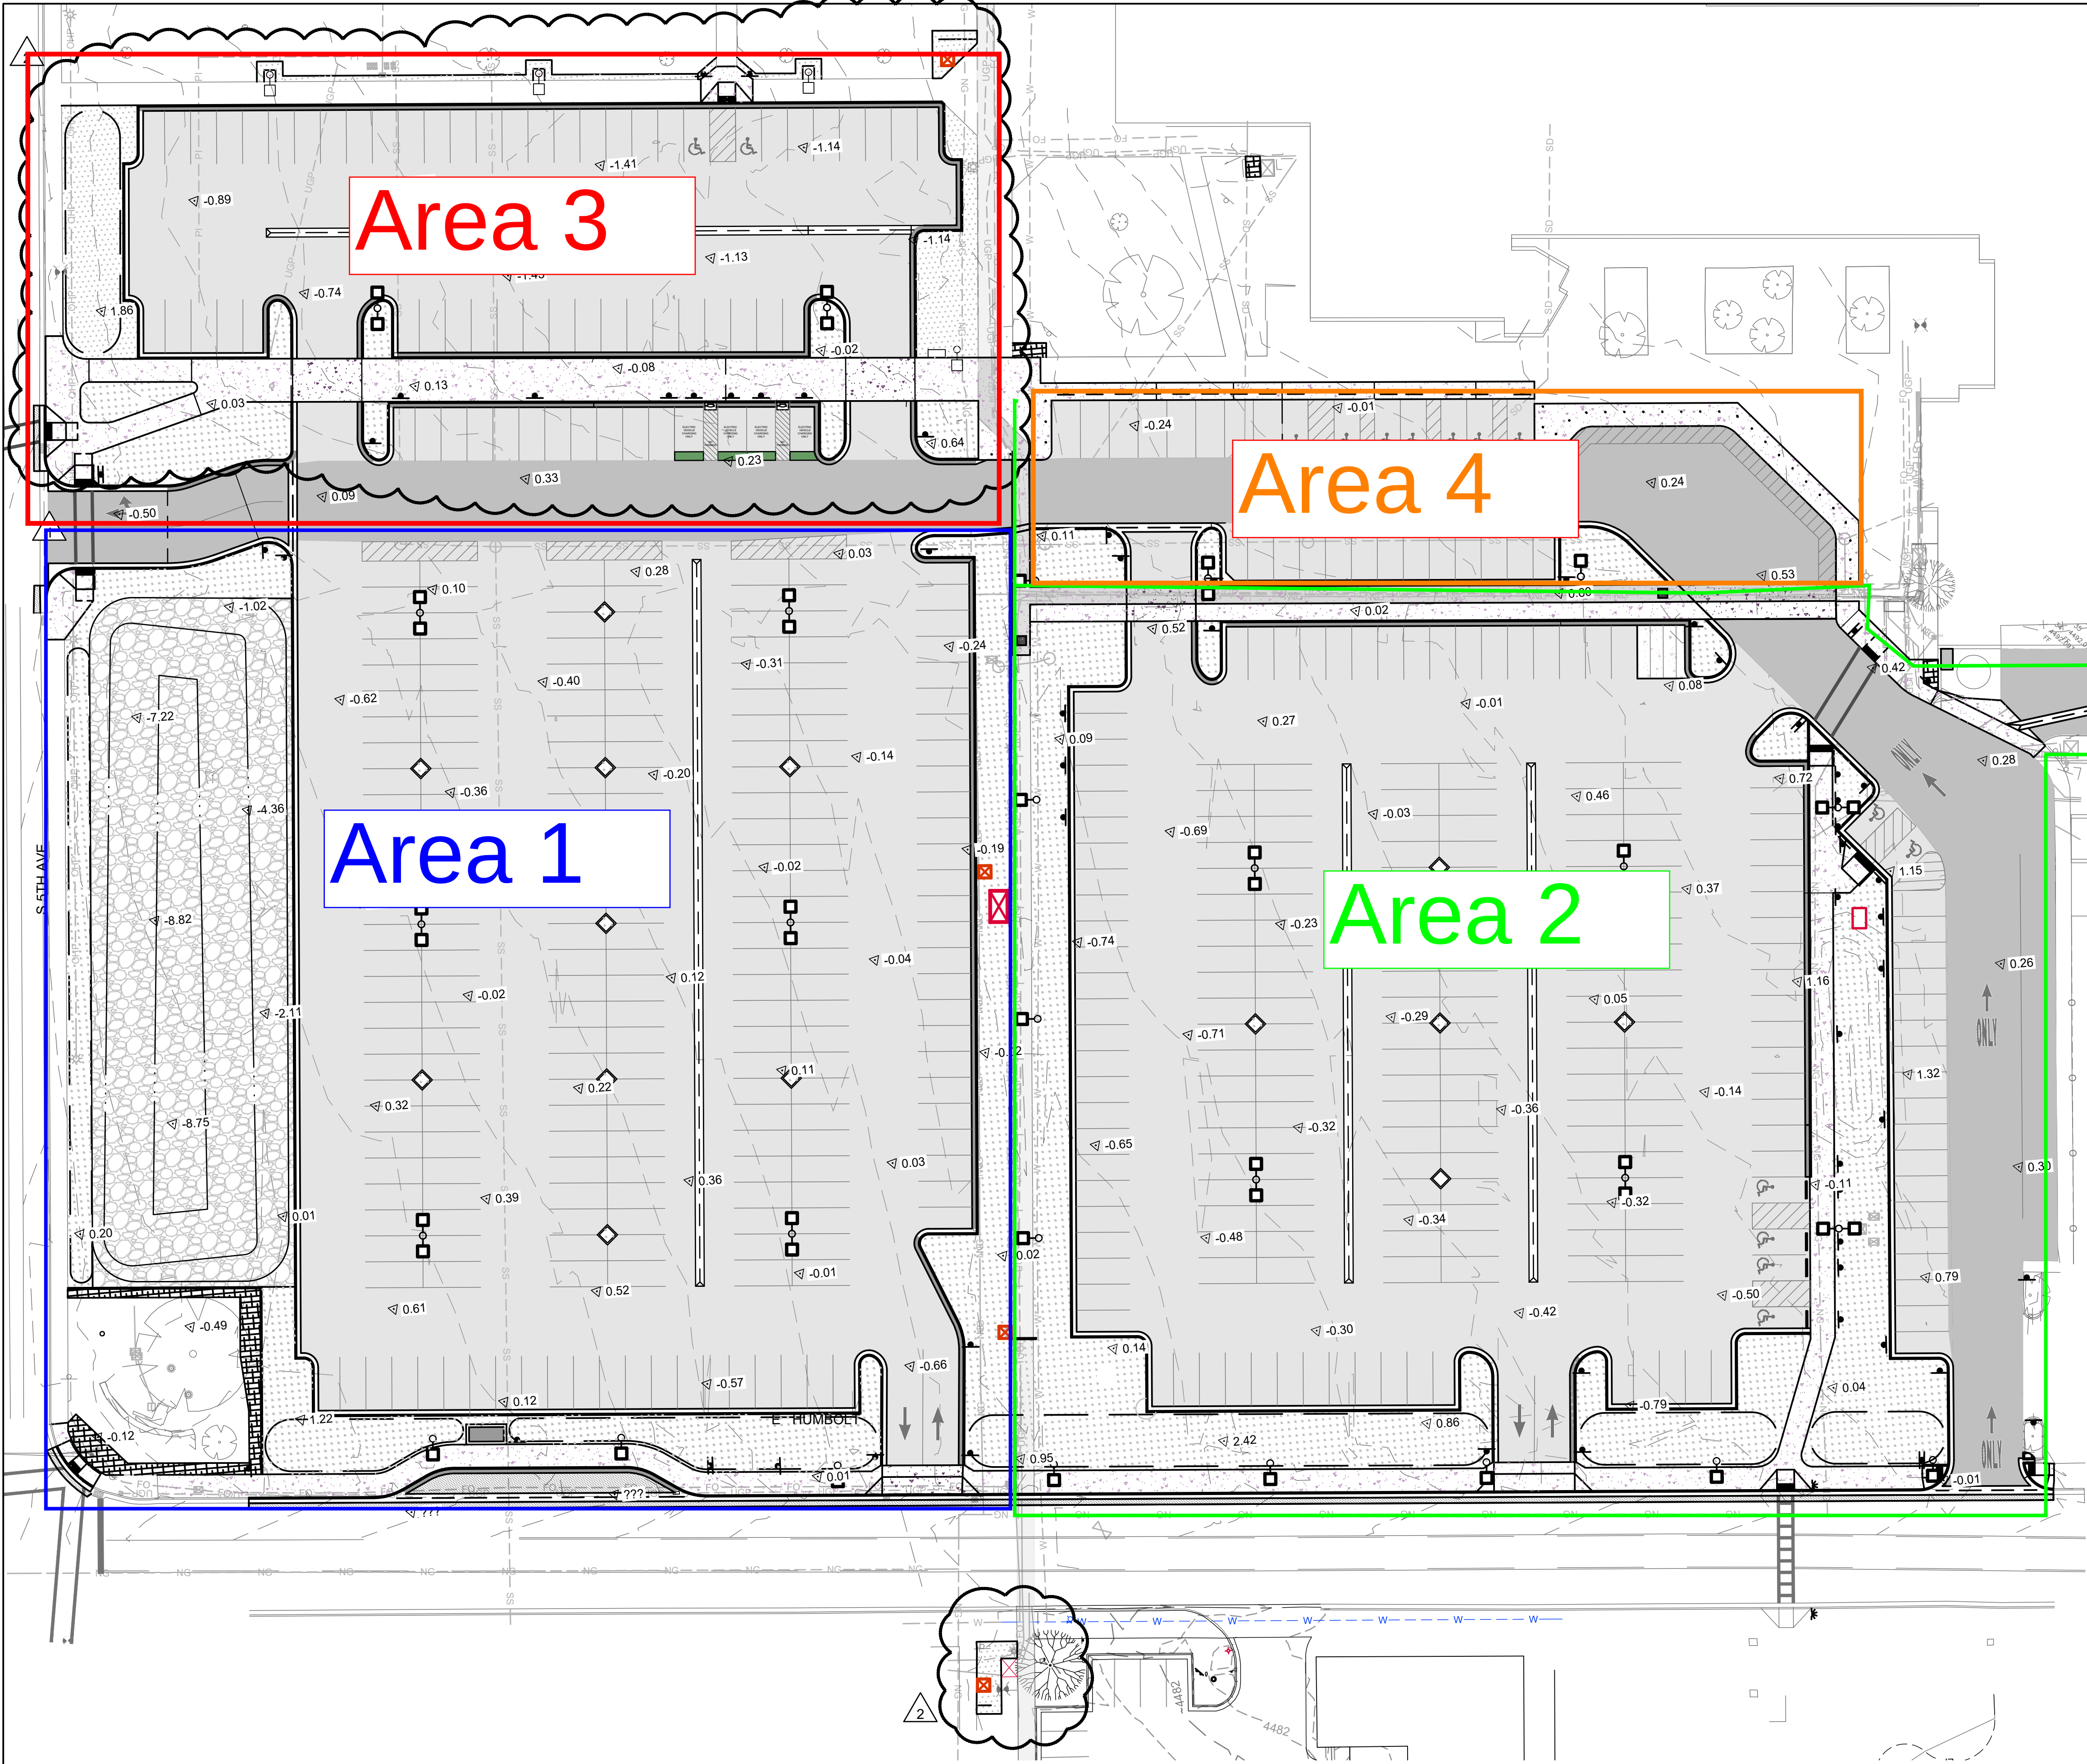

EARTHWORK QUANTITIES

UNADJUSTED EXCAVATION:	
UNADJUSTED CUT	= 5,409 CU.YD.
UNADJUSTED FILL	= 2,069 CU.YD.
TOTAL UNADJUSTED CUT	= 3,340 CU. YD.

1


2

- VOLUMES ARE UNADJUSTED AND AND ESTIMATES FOR COMPACTION ARE NOT INCLUDED.
- VOLUMES ARE CALCULATED BY COMPARING THE EXISTING SURFACE AND THE FINAL DESIGN GRADES.
- VOLUMES DO NOT ACCOUNT FOR POOR SOIL CONDITIONS.
- TOTAL UNADJUSTED CUT INCLUDES GRUBBING.
- CALCULATIONS ARE AN ESTIMATE ONLY AND ARE PROVIDED FOR PERMITTING AND INFORMATION ONLY.
- CONTRACTOR TO DETERMINE SITE EARTHWORK QUANTITIES AND BID ACCORDINGLY.

LEGEND

CUT / FILL DEPTHS	
△ -3.37	CUT DEPTH
△ 2.52	FILL DEPTH

- CUT / FILL DEPTHS ARE AN ESTIMATE ONLY AND PROVIDED FOR INFORMATION ONLY.
- CUT/FILL DEPTHS ARE CALCULATED BY COMPARING THE EXISTING SURFACE AND THE FINAL DESIGN GRADES.

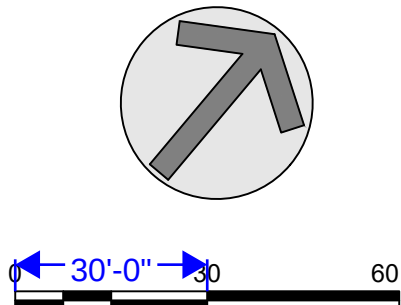

100 East Bower Street, Suite 110
Meridian, ID 83642
(208) 288-1992

PROFESSIONAL ENGINEER
MATTHEW B. HILL
15381
3/9/2024
STATE OF IDAHO

2	REVISION #2	05/08/2024
1	REVISION #1	04/01/2024

NO. REVISIONS DATE

This document or any part thereof in detail or design concept is the personal property of Keller Associates, Inc. and shall not be copied in any form without the written authorization of Keller Associates, Inc.

IDAHO STATE UNIVERSITY

G1 PARKING LOT

SITE GRADING CUT-FILL PLAN

DRAWN: CHECK:

VERIFY SCALE: Scales based on 22"x34" prints.

PROJECT NO. 223050-002

SHEET NO. C-200